


APPENDIX I

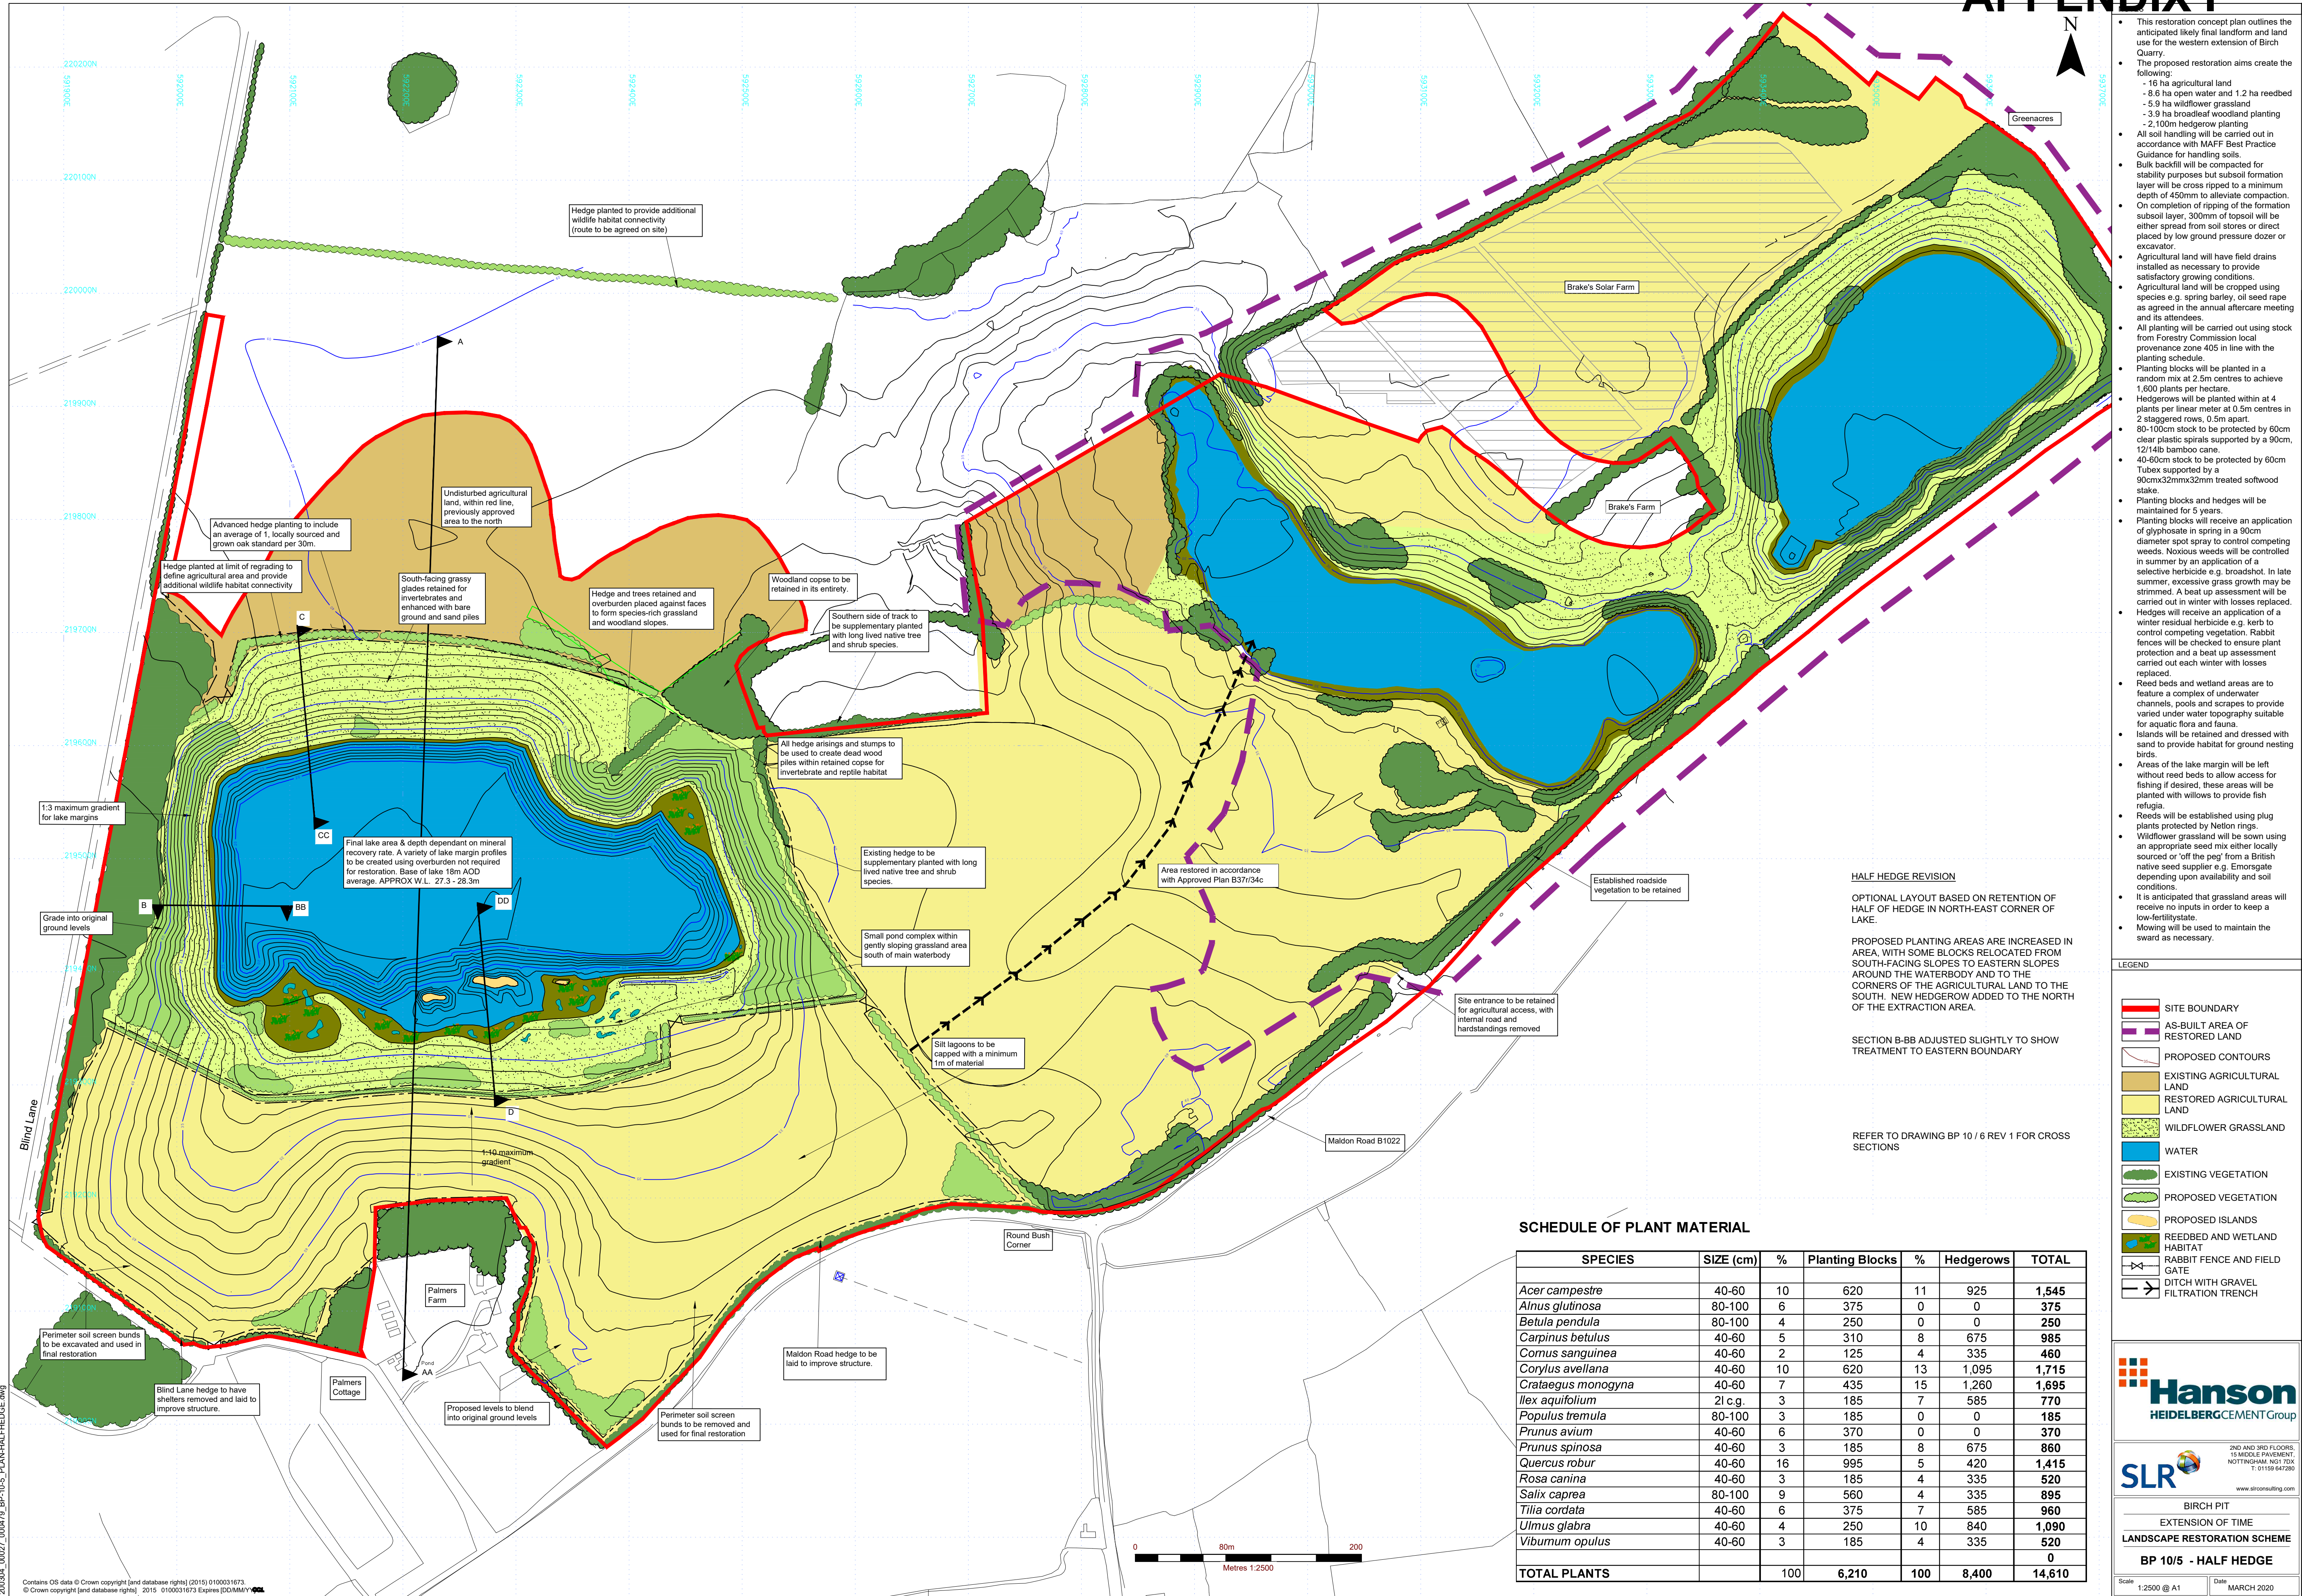

- This restoration concept plan outlines the anticipated likely final landform and land use for the western extension of Birch Quarry.
- The proposed restoration aims create the following:
 - 16 ha agricultural land
 - 8.6 ha open water and 1.2 ha reedbed
 - 5.9 ha wildflower grassland
 - 3.9 ha broadleaf woodland planting
 - 2,100m hedgerow planting
- All soil handling will be carried out in accordance with MAFF Best Practice Guidance for handling soils.
- Bulk backfill will be compacted for stability purposes but subsoil formation layer will be cross ripped to a minimum depth of 450mm to alleviate compaction.
- On completion of ripping of the formation subsoil layer, 300mm of topsoil will be either spread from soil stores or direct placed by low ground pressure dozer or excavator
- Agricultural land will have field drains installed as necessary to provide satisfactory growing conditions.
- Agricultural land will be cropped using species e.g. spring barley, oil seed rape as agreed in the annual aftercare meeting and its attendees.
- All planting will be carried out using stock from Forestry Commission local provenance zone 405 in line with the planting schedule.
- Planting blocks will be planted in a random mix at 2.5m centres to achieve 1,600 plants per hectare.
- Hedgerows will be planted within at 4 plants per linear meter at 0.5m centres in 2 staggered rows, 0.5m apart.
- 80-100cm stock to be protected by 60cm clear plastic spirals supported by a 90cm, 12/14lb bamboo cane.
- 40-60cm stock to be protected by 60cm Tubex supported by a 90cmx32mmx32mm treated softwood stake.
- Planting blocks and hedges will be maintained for 5 years.
- Planting blocks will receive an application of glyphosate in spring in a 90cm diameter spot spray to control competing weeds. Noxious weeds will be controlled in summer by an application of a selective herbicide e.g. broadshot. In late summer, excessive grass growth may be strimmed. A beat up assessment will be carried out in winter with losses replaced.
- Hedges will receive an application of a winter residual herbicide e.g. kerb to control competing vegetation. Rabbit fences will be checked to ensure plant protection and a beat up assessment carried out each winter with losses replaced.
- Reed beds and wetland areas are to feature a complex of underwater channels, pools and scrapes to provide varied under water topography suitable for aquatic flora and fauna.
- Islands will be retained and dressed with sand to provide habitat for ground nesting birds.
- Areas of the lake margin will be left without reed beds to allow access for fishing if desired, these areas will be planted with willows to provide fish refugia.
- Reeds will be established using plug plants protected by Nettle rings.
- Wildflower grassland will be sown using an appropriate seed mix either locally sourced or 'off the peg' from a British native seed supplier e.g. Emorsgate depending upon availability and soil conditions.
- It is anticipated that grassland areas will receive no inputs in order to keep a low-fertility state.
- Mowing will be used to maintain the sward as necessary.

- LEGEND
- SITE BOUNDARY
 - AS-BUILT AREA OF RESTORED LAND
 - PROPOSED CONTOURS
 - EXISTING AGRICULTURAL LAND
 - RESTORED AGRICULTURAL LAND
 - WILDFLOWER GRASSLAND
 - WATER
 - EXISTING VEGETATION
 - PROPOSED VEGETATION
 - PROPOSED ISLANDS
 - REEDBED AND WETLAND HABITAT
 - RABBIT FENCE AND FIELD GATE
 - DITCH WITH GRAVEL
 - FILTRATION TRENCH

SCHEDULE OF PLANT MATERIAL

SPECIES	SIZE (cm)	%	Planting Blocks	%	Hedgerows	TOTAL
<i>Acer campestre</i>	40-60	10	620	11	925	1,545
<i>Alnus glutinosa</i>	80-100	6	375	0	0	375
<i>Betula pendula</i>	80-100	4	250	0	0	250
<i>Carpinus betulus</i>	40-60	5	310	8	675	985
<i>Comus sanguinea</i>	40-60	2	125	4	335	460
<i>Corylus avellana</i>	40-60	10	620	13	1,095	1,715
<i>Crataegus monogyna</i>	40-60	7	435	15	1,260	1,695
<i>Ilex aquifolium</i>	2l c.g.	3	185	7	585	770
<i>Populus tremula</i>	80-100	3	185	0	0	185
<i>Prunus avium</i>	40-60	6	370	0	0	370
<i>Prunus spinosa</i>	40-60	3	185	8	675	860
<i>Quercus robur</i>	40-60	16	995	5	420	1,415
<i>Rosa canina</i>	40-60	3	185	4	335	520
<i>Salix caprea</i>	80-100	9	560	4	335	895
<i>Tilia cordata</i>	40-60	6	375	7	585	960
<i>Ulmus glabra</i>	40-60	4	250	10	840	1,090
<i>Viburnum opulus</i>	40-60	3	185	4	335	520
TOTAL PLANTS		100	6,210	100	8,400	14,610

HALF HEDGE REVISION

OPTIONAL LAYOUT BASED ON RETENTION OF HALF OF HEDGE IN NORTH-EAST CORNER OF LAKE.

PROPOSED PLANTING AREAS ARE INCREASED IN AREA, WITH SOME BLOCKS RELOCATED FROM SOUTH-FACING SLOPES TO EASTERN SLOPES AROUND THE WATERBODY AND TO THE CORNERS OF THE AGRICULTURAL LAND TO THE SOUTH. NEW HEDGEROW ADDED TO THE NORTH OF THE EXTRACTION AREA.

SECTION B-BB ADJUSTED SLIGHTLY TO SHOW TREATMENT TO EASTERN BOUNDARY

REFER TO DRAWING BP 10 / 6 REV 1 FOR CROSS SECTIONS

200304_00027_000479_BP-10-5_PLAN-HALF-HEDGE.dwg

Contains OS data © Crown copyright [and database rights] (2015) 0100031673.
© Crown copyright [and database rights] 2015 0100031673 Expires (DD/MM/YY) 2020

© This drawing and its content are the copyright of SLR Consulting Ltd and may not be reproduced or amended except by prior written permission. SLR Consulting Ltd accepts no liability for any amendments made by other persons.